



© Eberhard Behr GmbH
 Design - Survey - Linemarking
 Alfred-Bozi-Str. 18 - D 33602 Bielefeld
 Tel.: +49-521-175998; Fax +49-521-179944
 e-mail EberBehr@aol.com - Germany

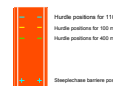

Run up's to 1 hurdle	Distance between hurdle	Run up's to finish
13.20 m	9.14 m	14.02 m
13.00 m	8.50 m	10.50 m
45.00 m	35.00 m	40.00 m

Project: National Stadium Bukit Jalil
 Kuala Lumpur - Malaysia
 Linemarking - as built drawing - Scale 1 : 250

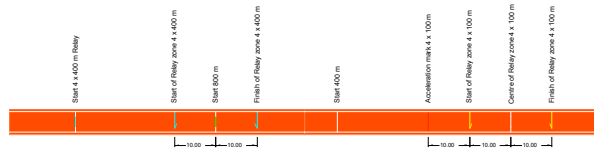